


AS BUILT

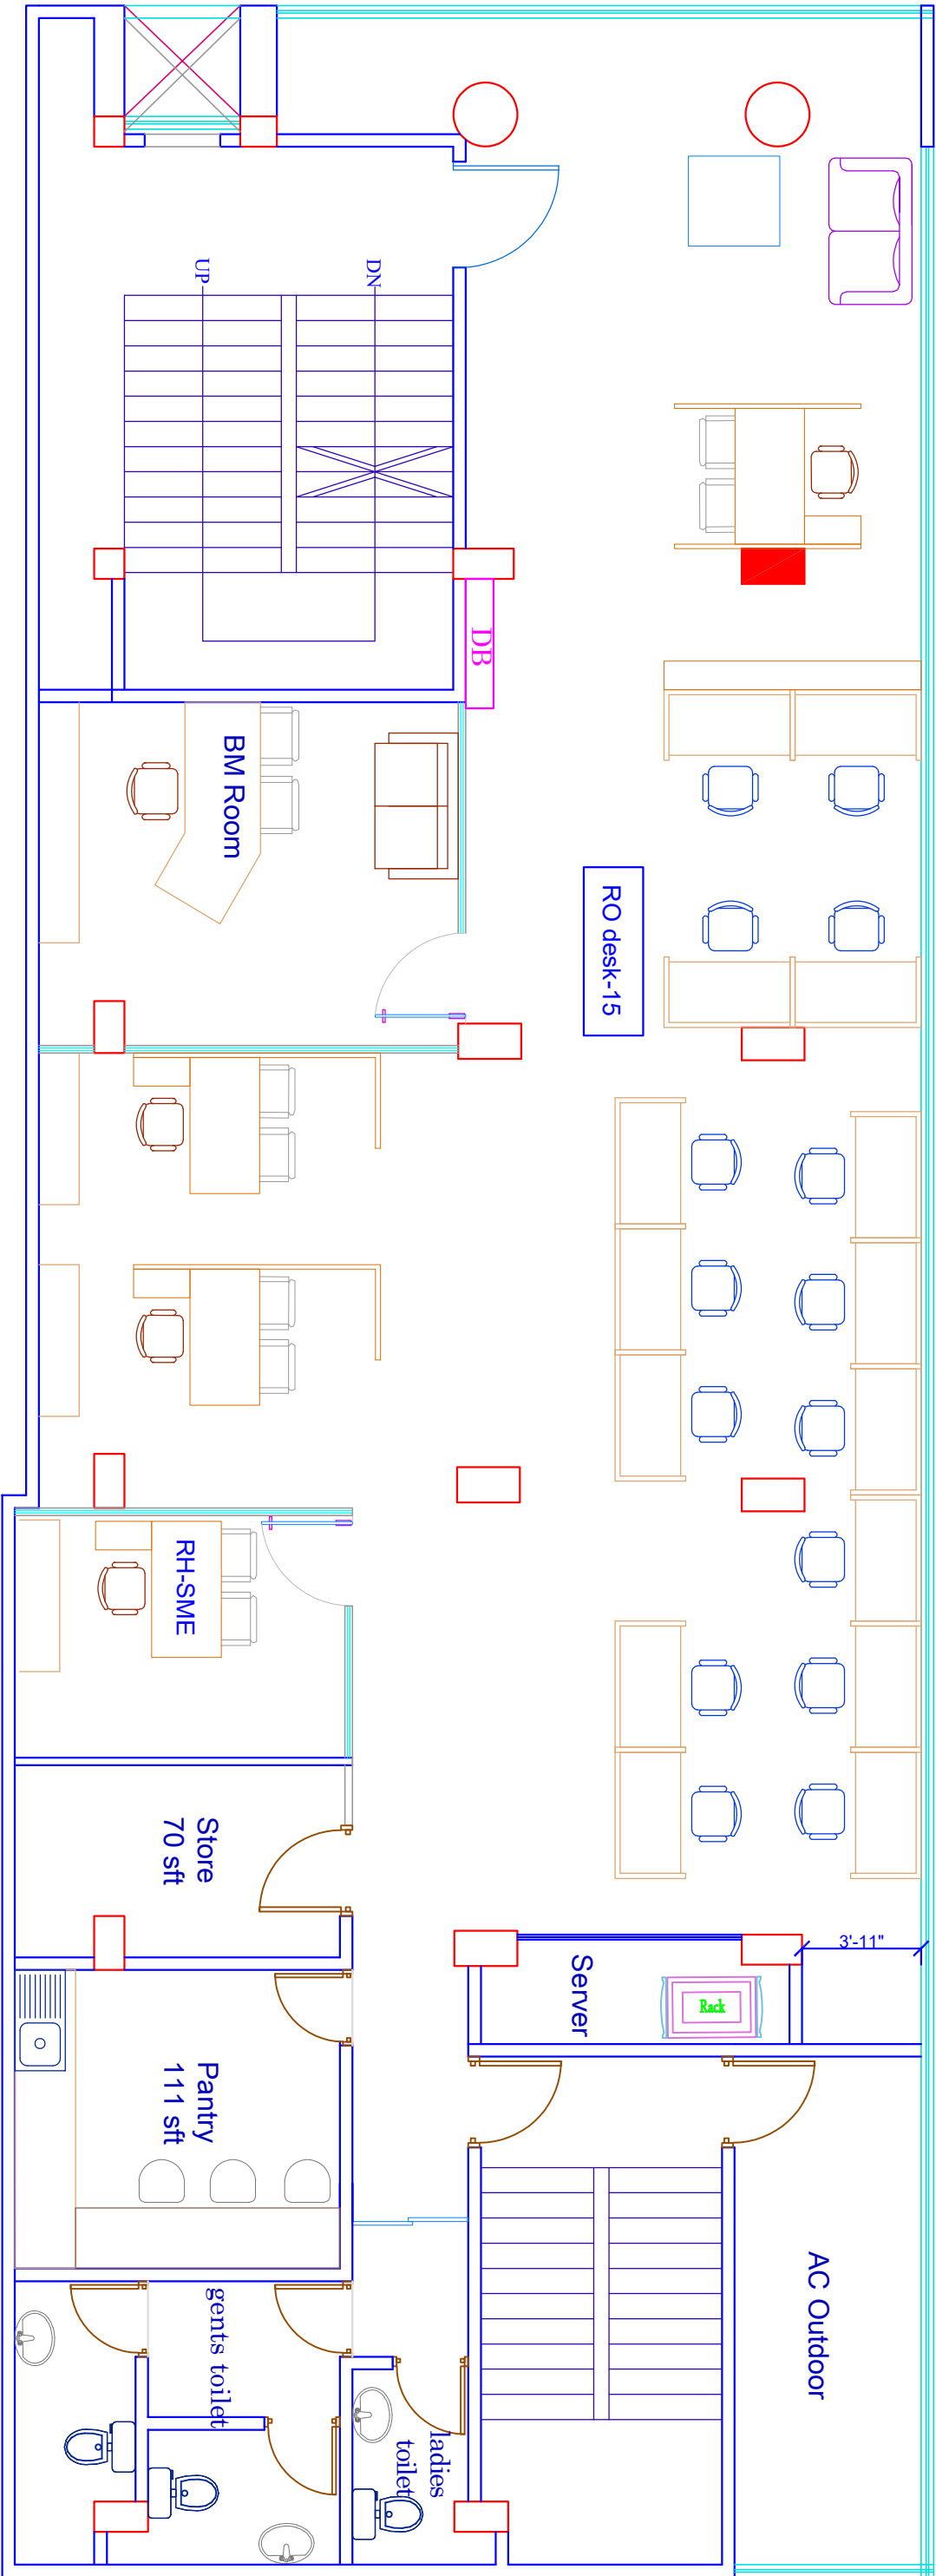

2ND FLOOR PLAN
FURNITURE LAYOUT PLAN

PROJECT	OWNERS	CONSULTANT	ARCHITECT/INTERIOR DESIGNER	DRAWING TITLE	DATE
BRAC BANK LTD. AT TONGI BOARD BAZAR	BRAC BANK LTD.	<div><div></div><div>TANYA KARIM N. R. KHAN AND ASSOCIATES.</div></div> <div>HOUSE NO. 24, ROAD NO. 9/A, DHANMONDI RA/ DHAKA-1209</div>	TANYA KARIM (K-051) N. R. KHAN (K-049) TAHMINA SIDDIQUE	FURNITURE LAYOUT PLAN	19.04.2017