


AS BUILT RANGPUR ROC

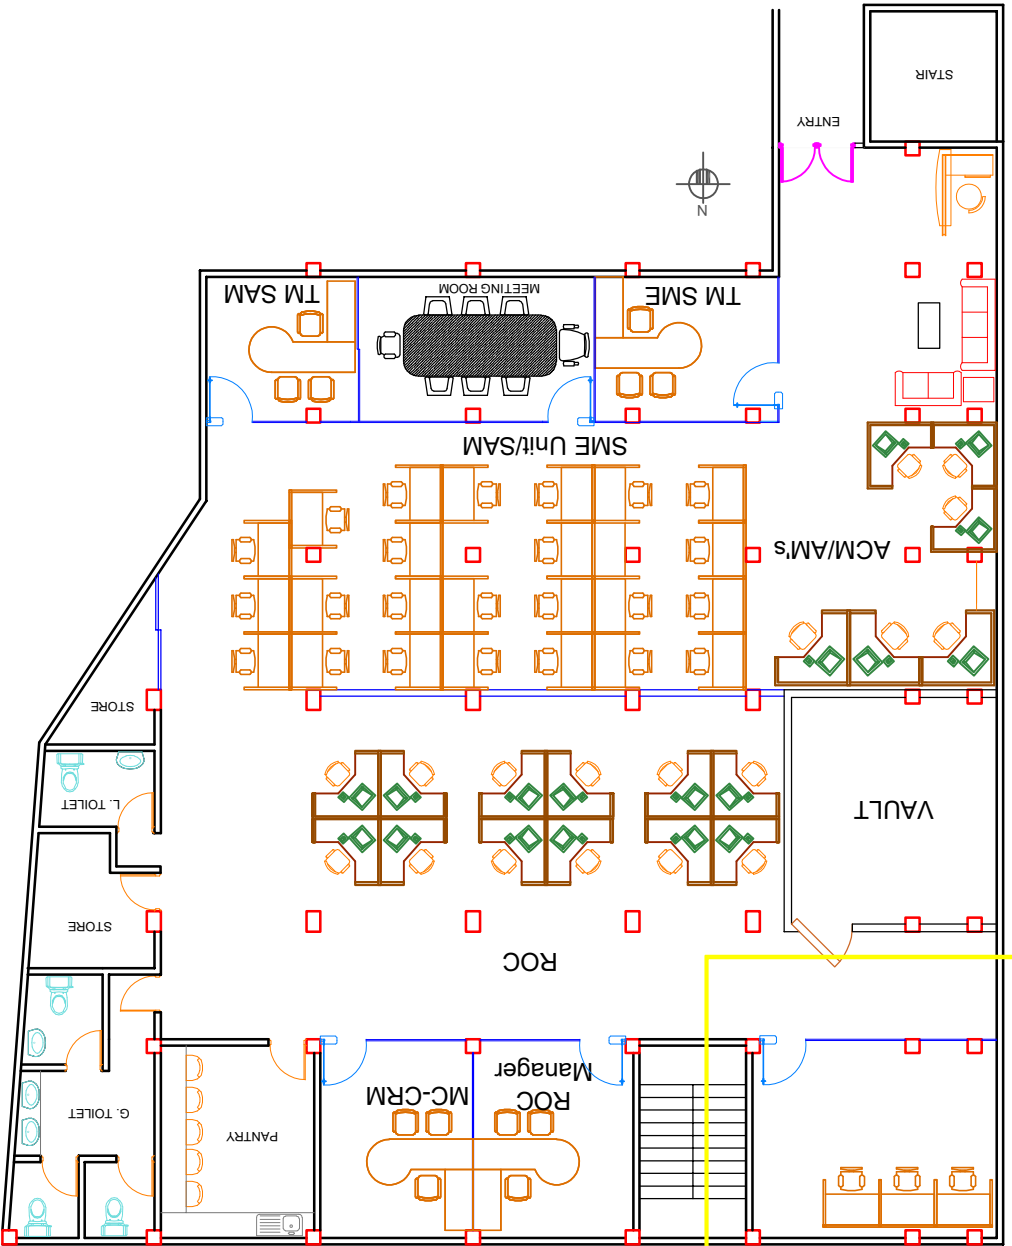

PROPOSED