


PROPOSED

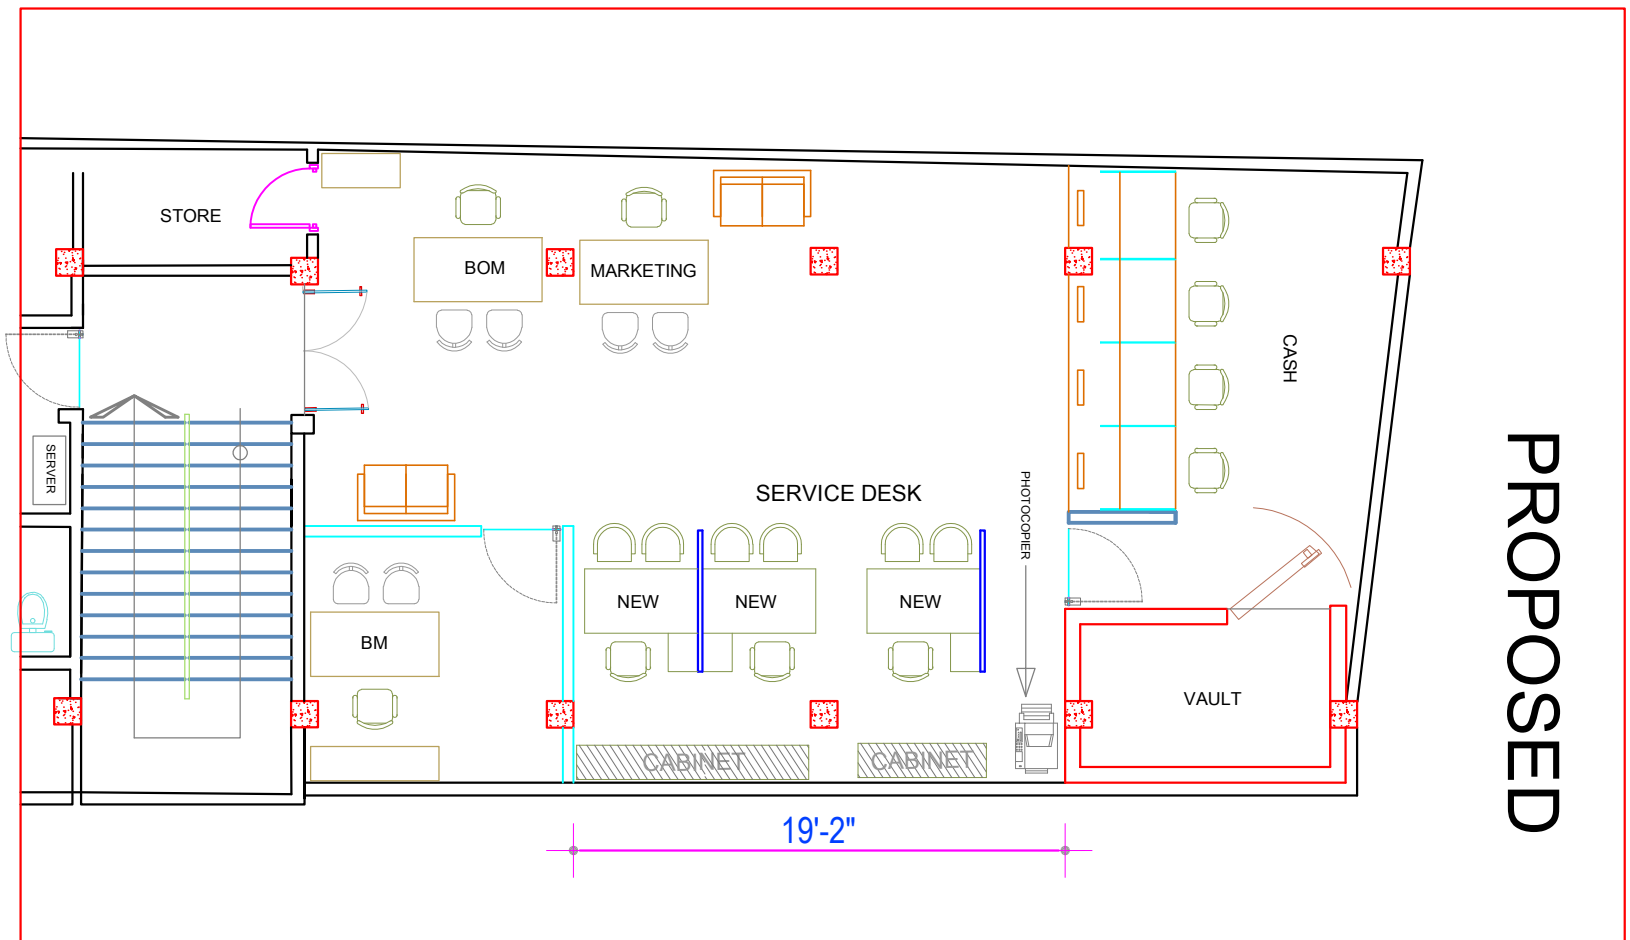

AS BUILT

